

850712004

my Property

That portion of the northwest quarter of the northwest quarter of Section 27 and that portion of Lot 6, River Glen Orchards, in Township 24 North, Range 18 East, W.M., described as beginning at a point on the West line of that parcel of land acquired by the State of Washington by deed recorded in Book 201, Page 484, Auditor's File No. 159844, Deed Records of Chelan County, which point is opposite Highway Engineer's Station 48+28 on the SR 2 Line Survey of SR 2, Jct. PSH No. 15 to Dryden, and 130 feet southwesterly therefrom; thence South 1°20' West along the West line of said recorded parcel to the southwest corner thereof; thence easterly along the South line of said recorded parcel 12 feet, more or less, to the southeast corner thereof; thence North 30°34' East along the East line of said recorded parcel to the southwest corner of that parcel of land acquired by the State of Washington by deed recorded in Book 203, Page 70, Auditor's File No. 161557, Deed Records of Chelan County; thence easterly along the South line of said recorded property to a point on a line that is 100 feet southwesterly of and parallel with, when measured at right angles and/or radially, from the said SR 2 Line Survey; thence northwesterly along said parallel line to a point opposite said Highway Engineer's Station 48+28; thence southwesterly to the point of beginning.

INCLUDED permission from Co.

MAKE COPIES 8-19-98



CHELAN COUNTY

DEPARTMENT OF PUBLIC WORKS
STATE OF WASHINGTON
COURTHOUSE

WENATCHEE, WASHINGTON 98801
TELEPHONE 509/664-5415

6-2-92

LLOYD L. BERRY, P.E.
DIRECTOR/COUNTY ENGINEER

TO WHOM IT MAY CONCERN.

C.L. ROOGER HAS PERMISSION TO USE
A SPRING ON PROPERTY OWNED BY CHELAN
COUNTY IN SECTION 27, T24N, R18E, W.M.
SAID SPRING IS APPROXIMATELY 20 FEET SOUTH
OF MR. ROOGER'S PROPERTY.


CHELAN COUNTY IS AWARE OF THE STATE
BOARD OF HEALTH REQUIREMENT TO NOT PLACE
CONTAMINATING STRUCTURES OR ACTIVITY WITHIN 200
FEET OF THIS SPRING.

CHELAN COUNTY HAS NO PLANS FOR USE
OF THIS SPRING.

L.L. Berry



Part of N.W. 1/4, N.W. 1/4 Section 27, T. 24 N., R. 18 E. W.M.
Chelan County, Washington

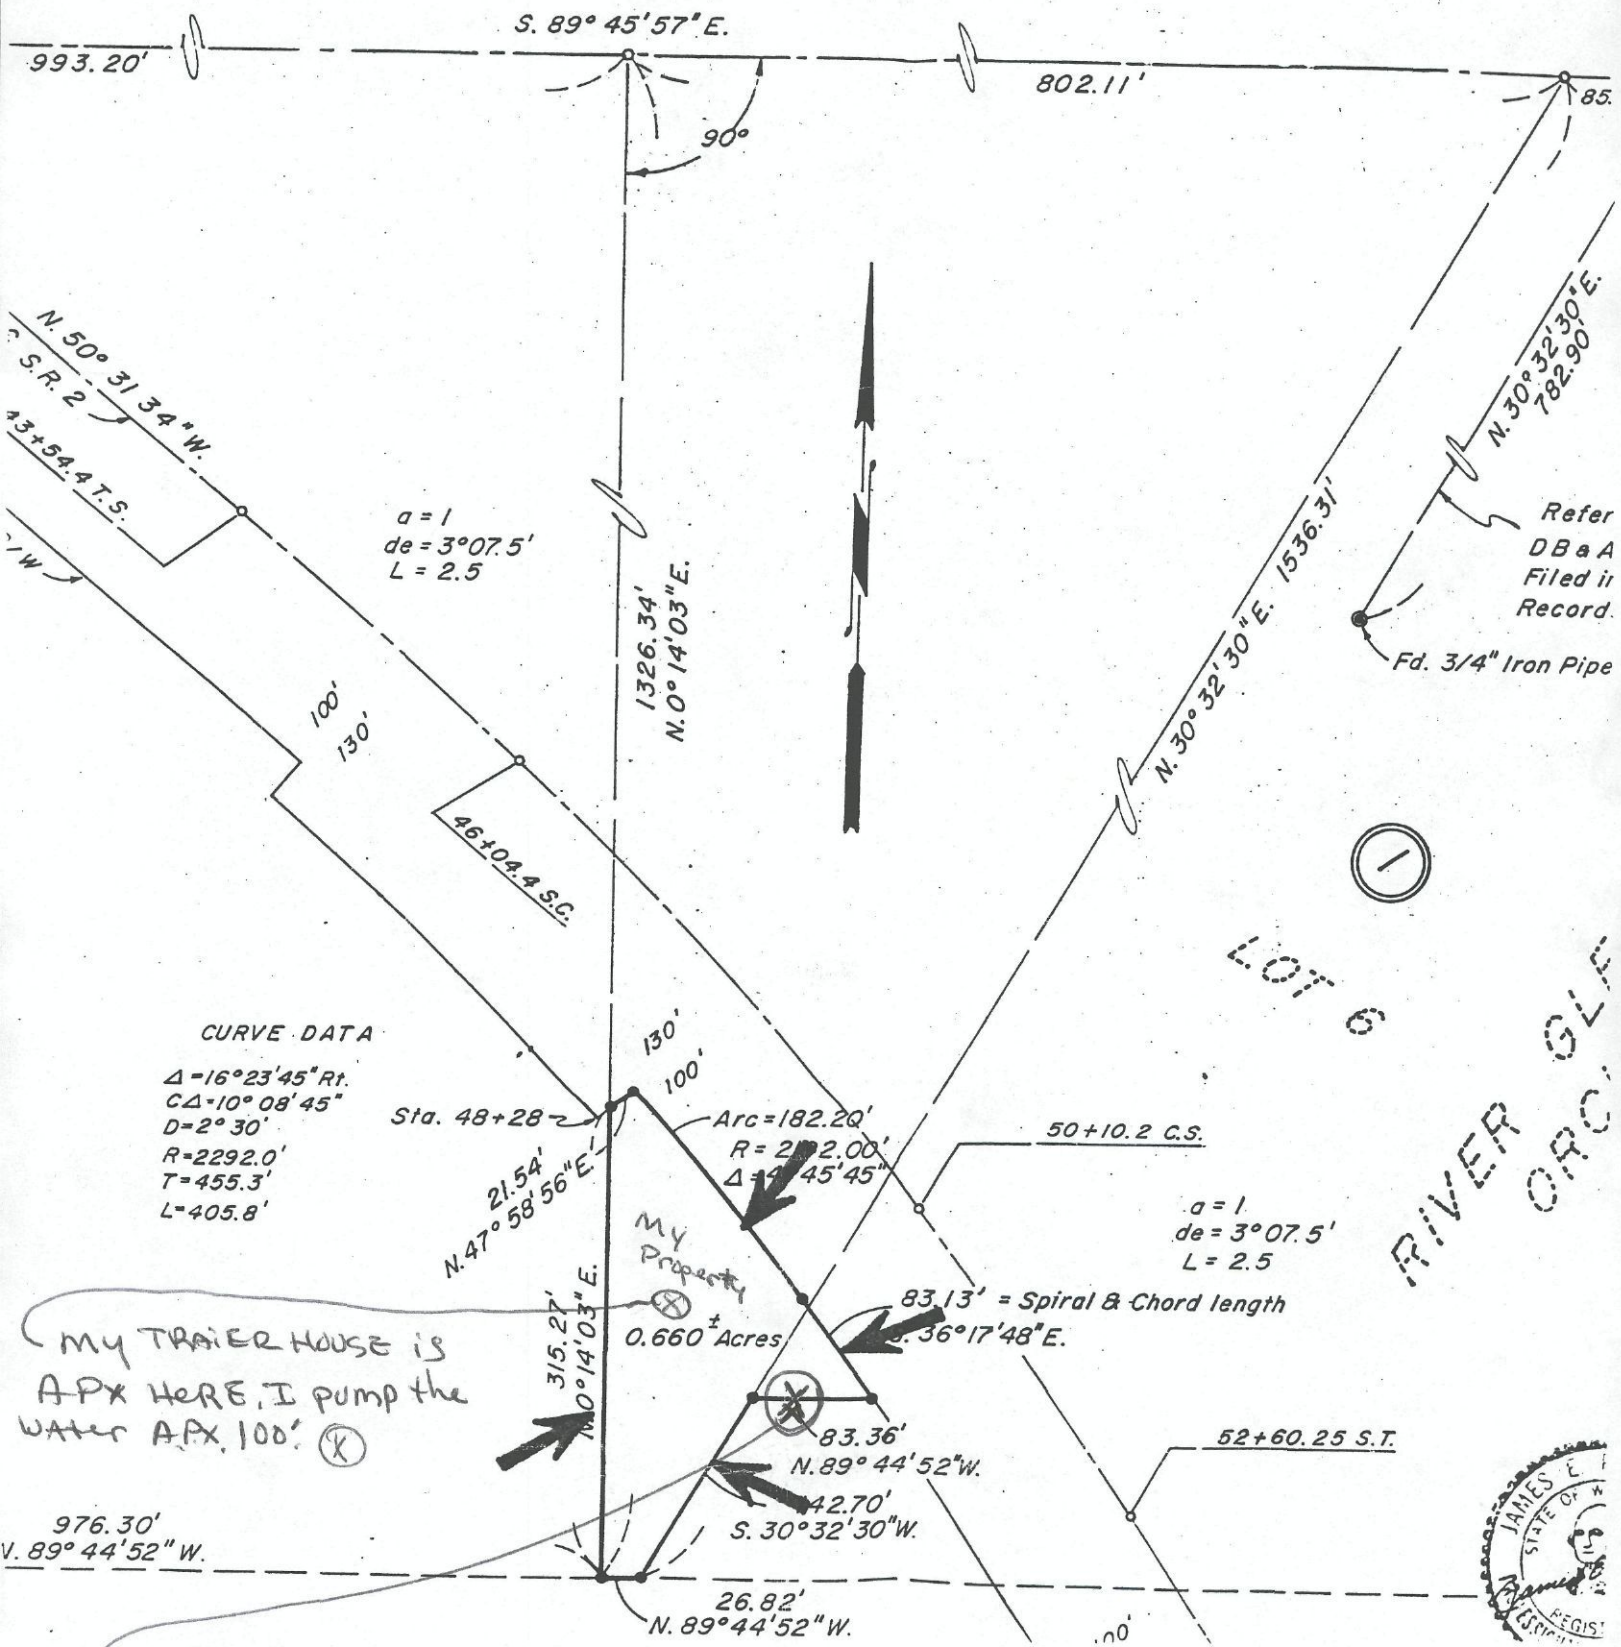

CURVE DATA

$\Delta = 16^\circ 23' 45''$ R.
 $C\Delta = 10^\circ 08' 45''$
 $D = 2^\circ 30'$
 $R = 2292.0'$
 $T = 455.3'$
 $L = 405.8'$

$a = 1$
 $de = 3^\circ 07.5'$
 $L = 2.5$

THIS SKETCH IS FURNISHED FOR INFORMATION PURPOSES
 ONLY TO ASSIST IN PROPERTY LOCATION WITH REFERENCE TO
 STREETS AND OTHER PARCELS. IT IS NOT GUARANTEED AS TO
 ACCURACY AND THE COMPANY ASSUMES NO LIABILITY FOR ANY
 LOSS OCCURRING BY REASON OF RELIANCE THEREON.

THE SPRING IS HERE
 APX. 12' over my line
 OWNED NOW BY CHELAN
 CO.

MY TRAILER HOUSE IS
 APX HERE, I PUMP THE
 WATER APX. 100' (X)

LOT 6
 RIVER GLE
 ORC





DESCRIPTION RECORD

See Wall Map

SCALE—1 inch=400 feet.
WENATCHEE PRINTING CO.

Section 27 Township 24 Range 18 School District 228

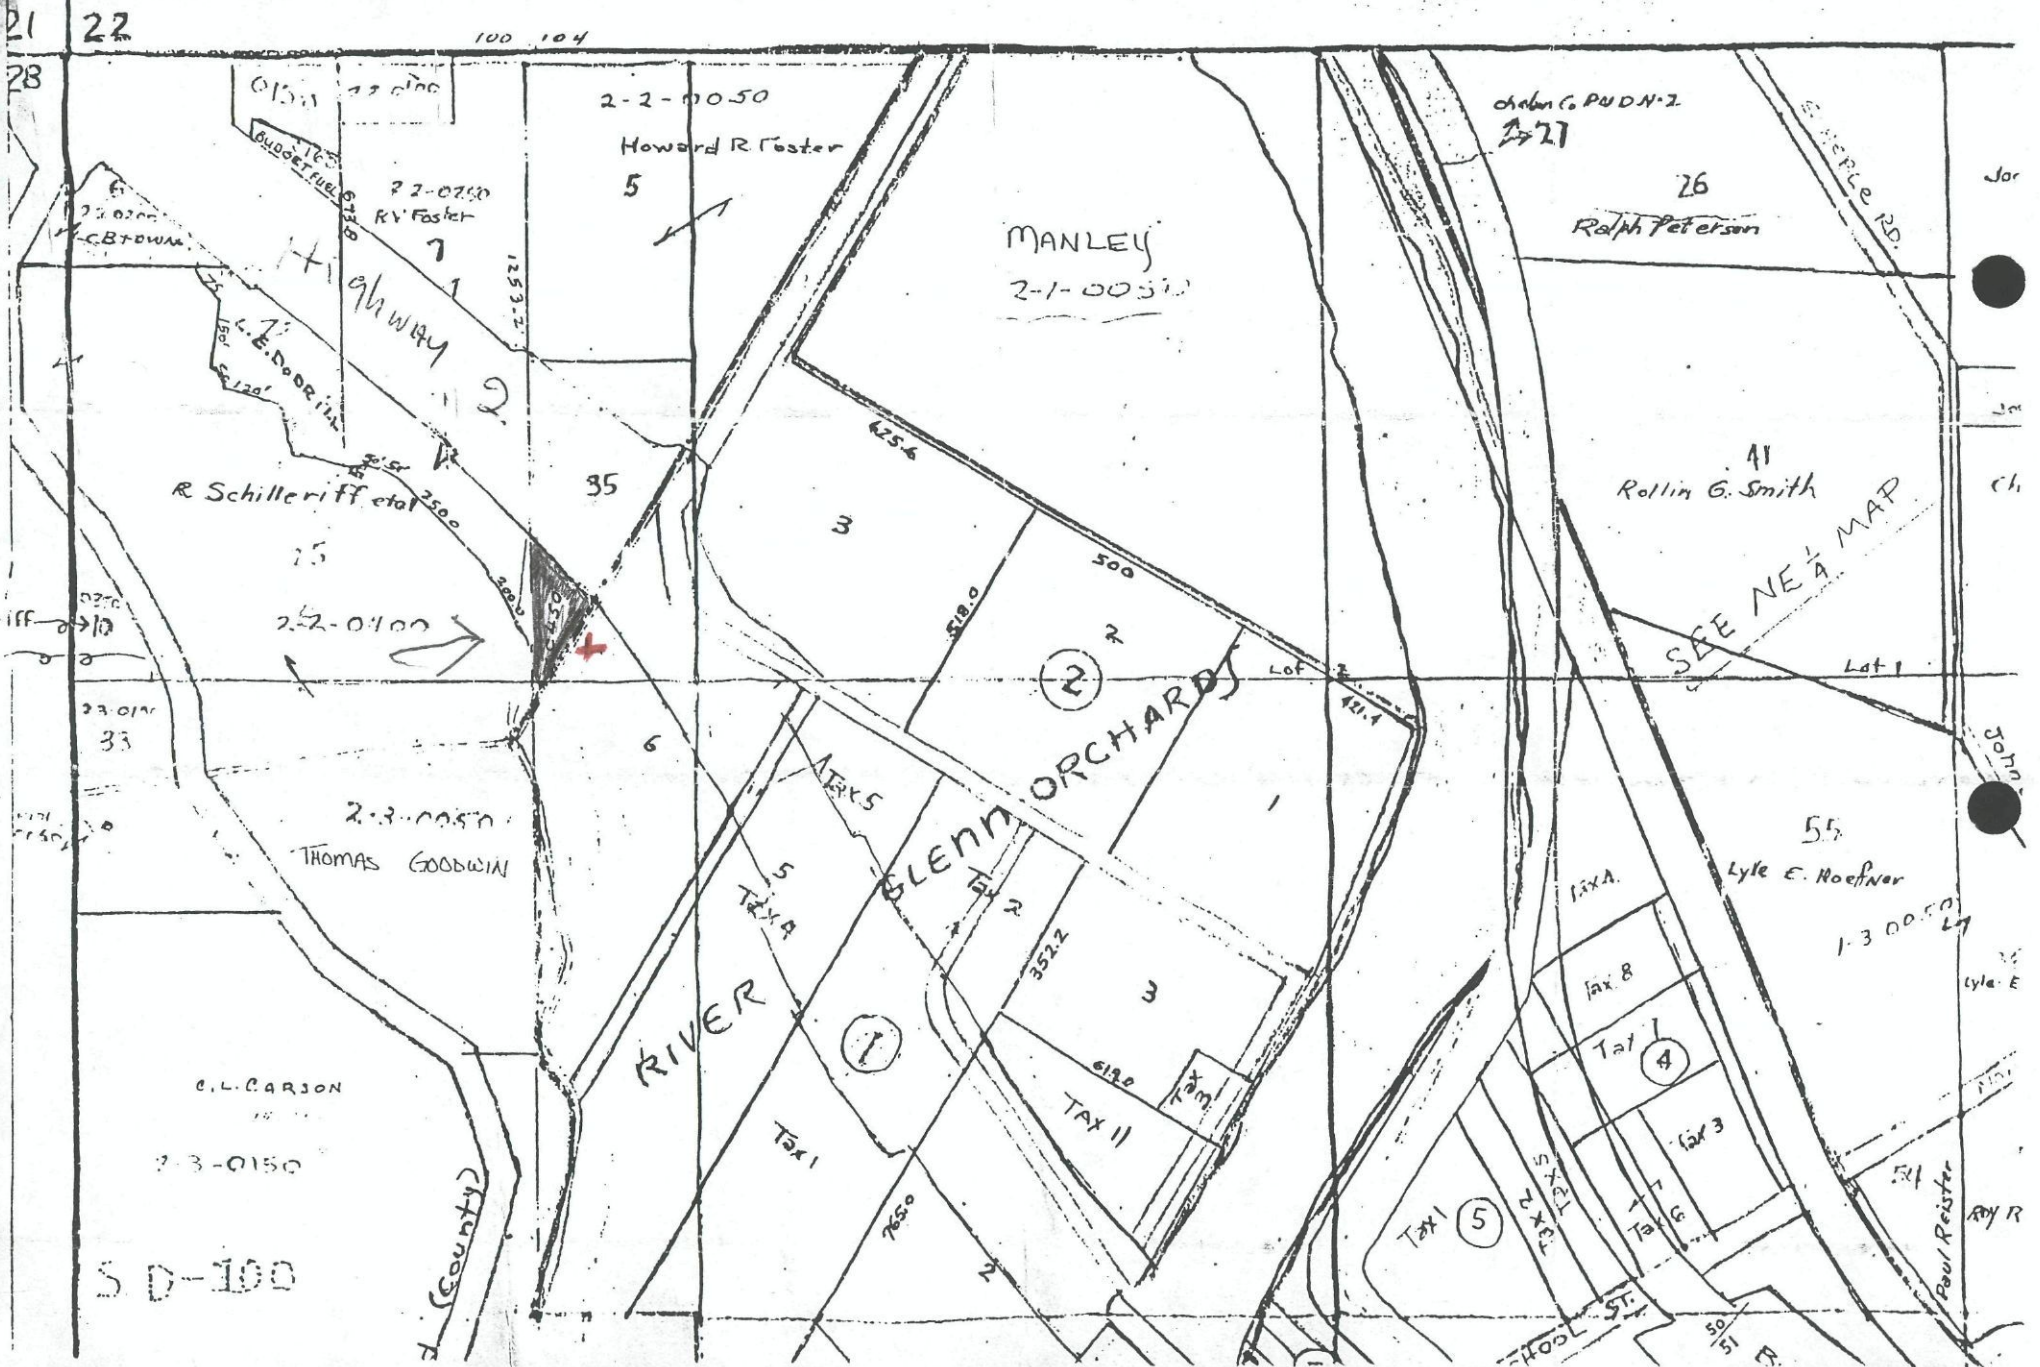

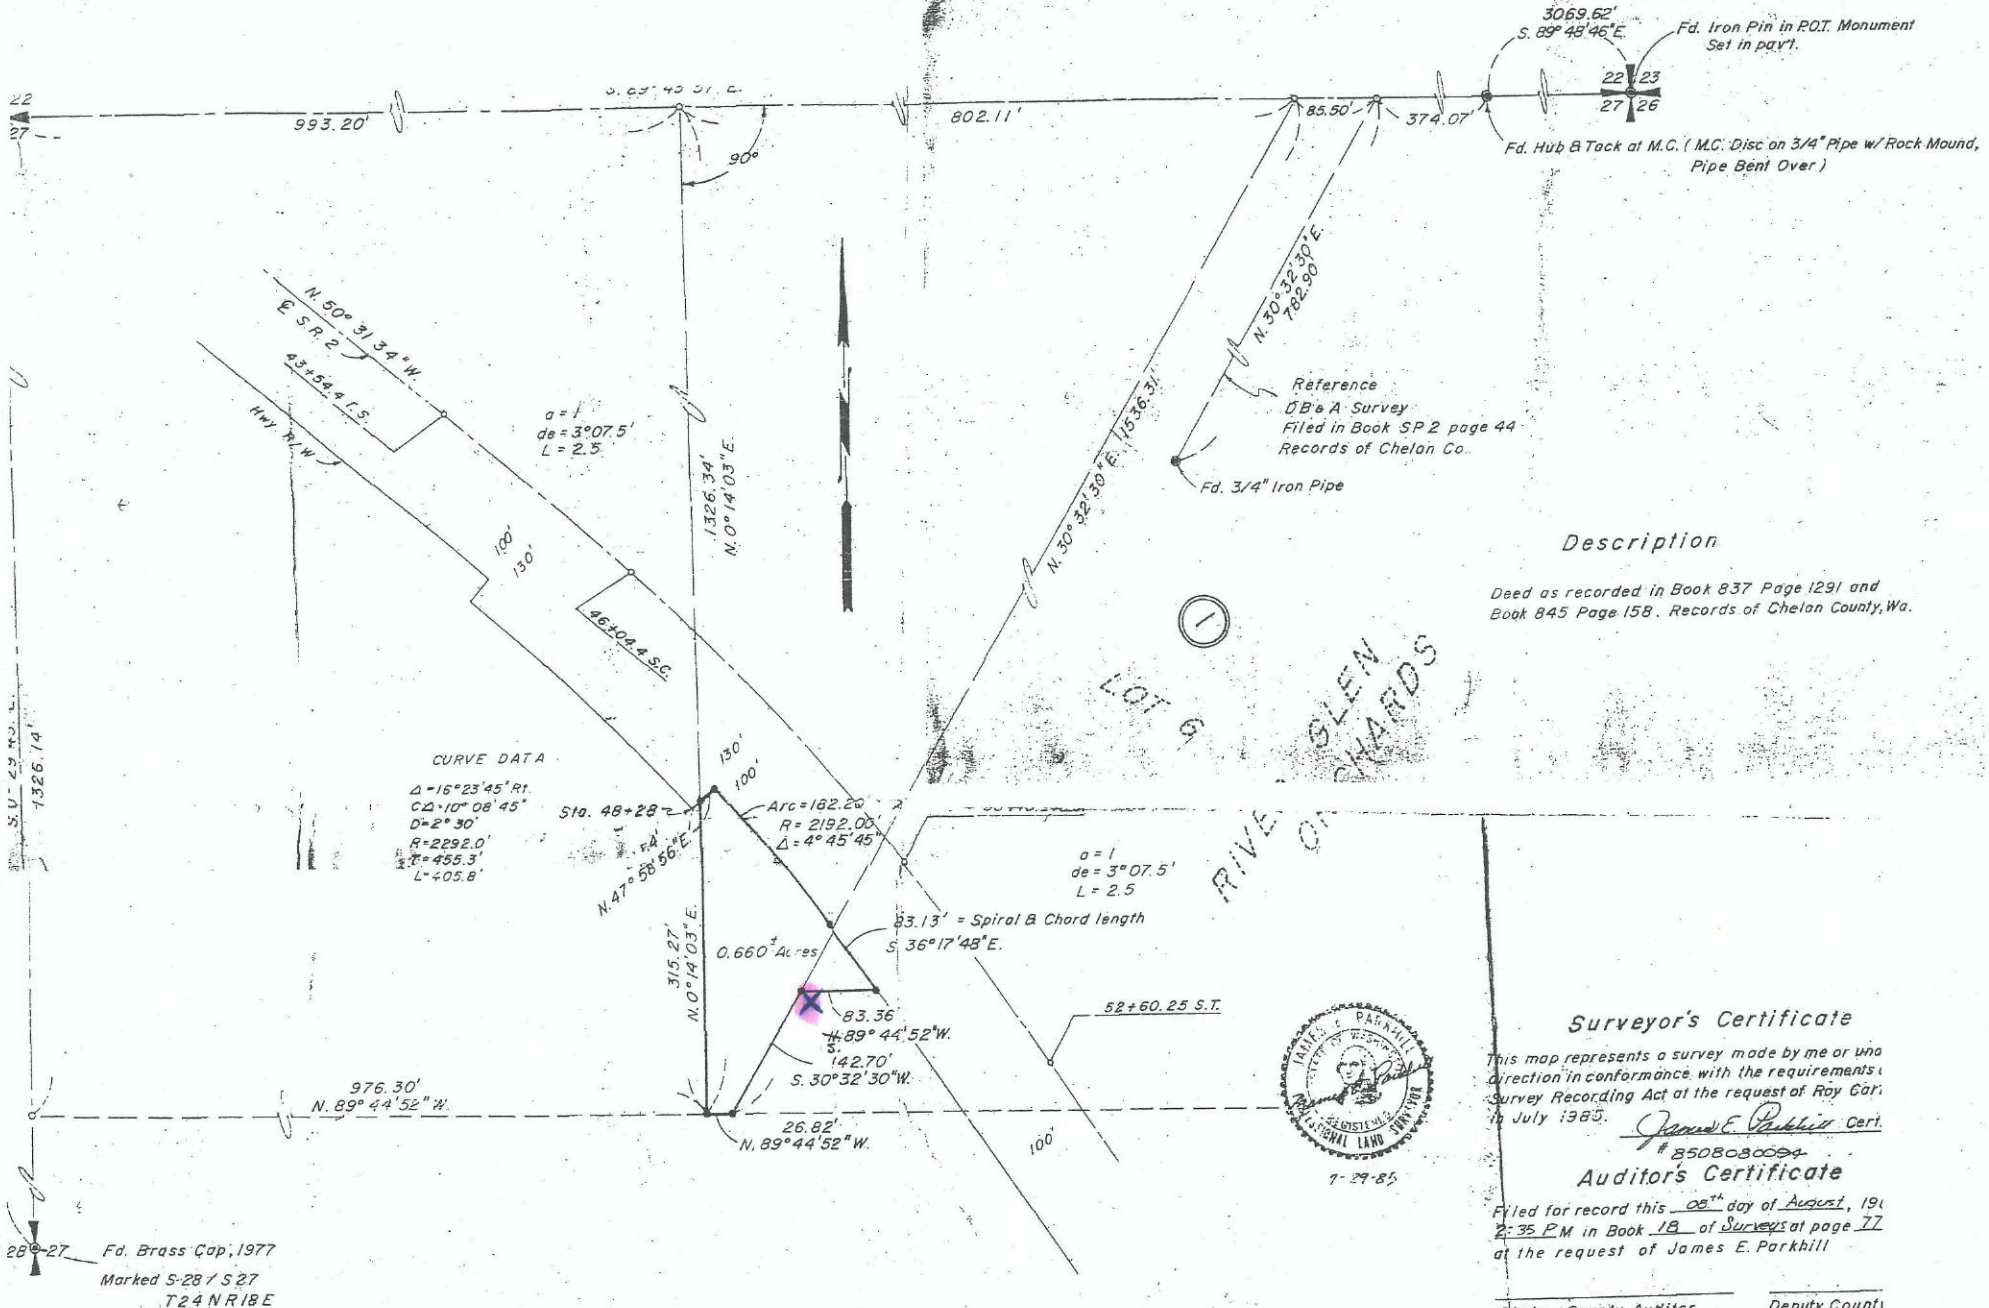

Description

Deed as recorded in Book 837 Page 1291 and Book 845 Page 158. Records of Chelan County, Wa.

Surveyor's Certificate

This map represents a survey made by me or on my direction in conformance with the requirements of the Survey Recording Act at the request of Roy Carriker in July 1985.

Auditor's Certificate

Filed for record this 06th day of August, 1985, at 2:35 P.M. in Book 18 of Surveys at page 77 at the request of James E. Parkhill

Chelan County Auditor Deputy County

James E. Parkhill Co.
P.O. Box 2261, Wenatchee, Wa. 98801
AUG 27 1985
RECORD SURVEY FOR ROY CARRIKER

Scale
1 inch = 100 feet

CL Rogers
9041 Highway 2
Cashmere, WA.
98815

98821



Dept of Ecology
15 W. YAKIMA AVE Ste 200
Yakima, WA,

98902-3452